


**KEY:**



	POWER		BOUNDARY
	TELECOM		STORMWATER MANHOLE
	GAS		WASTEWATER MANHOLE
	FIBRE		SLUICE VALVE
	SEWER		FIRE HYDRANT
	STORMWATER		
	WATER		

**NOTE:**  
 INVERTS ARE LISTED CLOCKWISE FROM OUTLET.  
 LOT CONNECTIONS ARE Ø100 UNLESS OTHERWISE SHOWN.

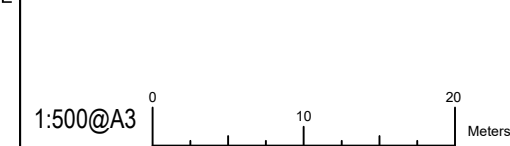


Datum: E: 447149.730  
 NZGD 2000 N: 675183.238  
 Moturiki 1953 H: 52.998

Revision	Amendment	Approved	Revision Date
A	Original Issue	J. M.	22-03-22

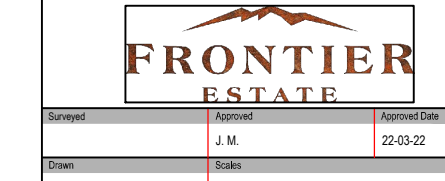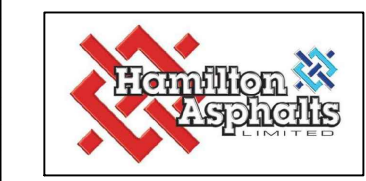

Project		
Frontier Estate Stage 4 Pirongia Rd, Te Awamutu		
Sheet		
STORMWATER SERVICE AS BUILT PLAN		
Surveyed	Approved	Approved Date
L. D.	J. M.	22-03-22
Drawn	Scales	Project No.
L. D.	1:500	8940-400-S01
Sheet No.	Revision	
001	A	

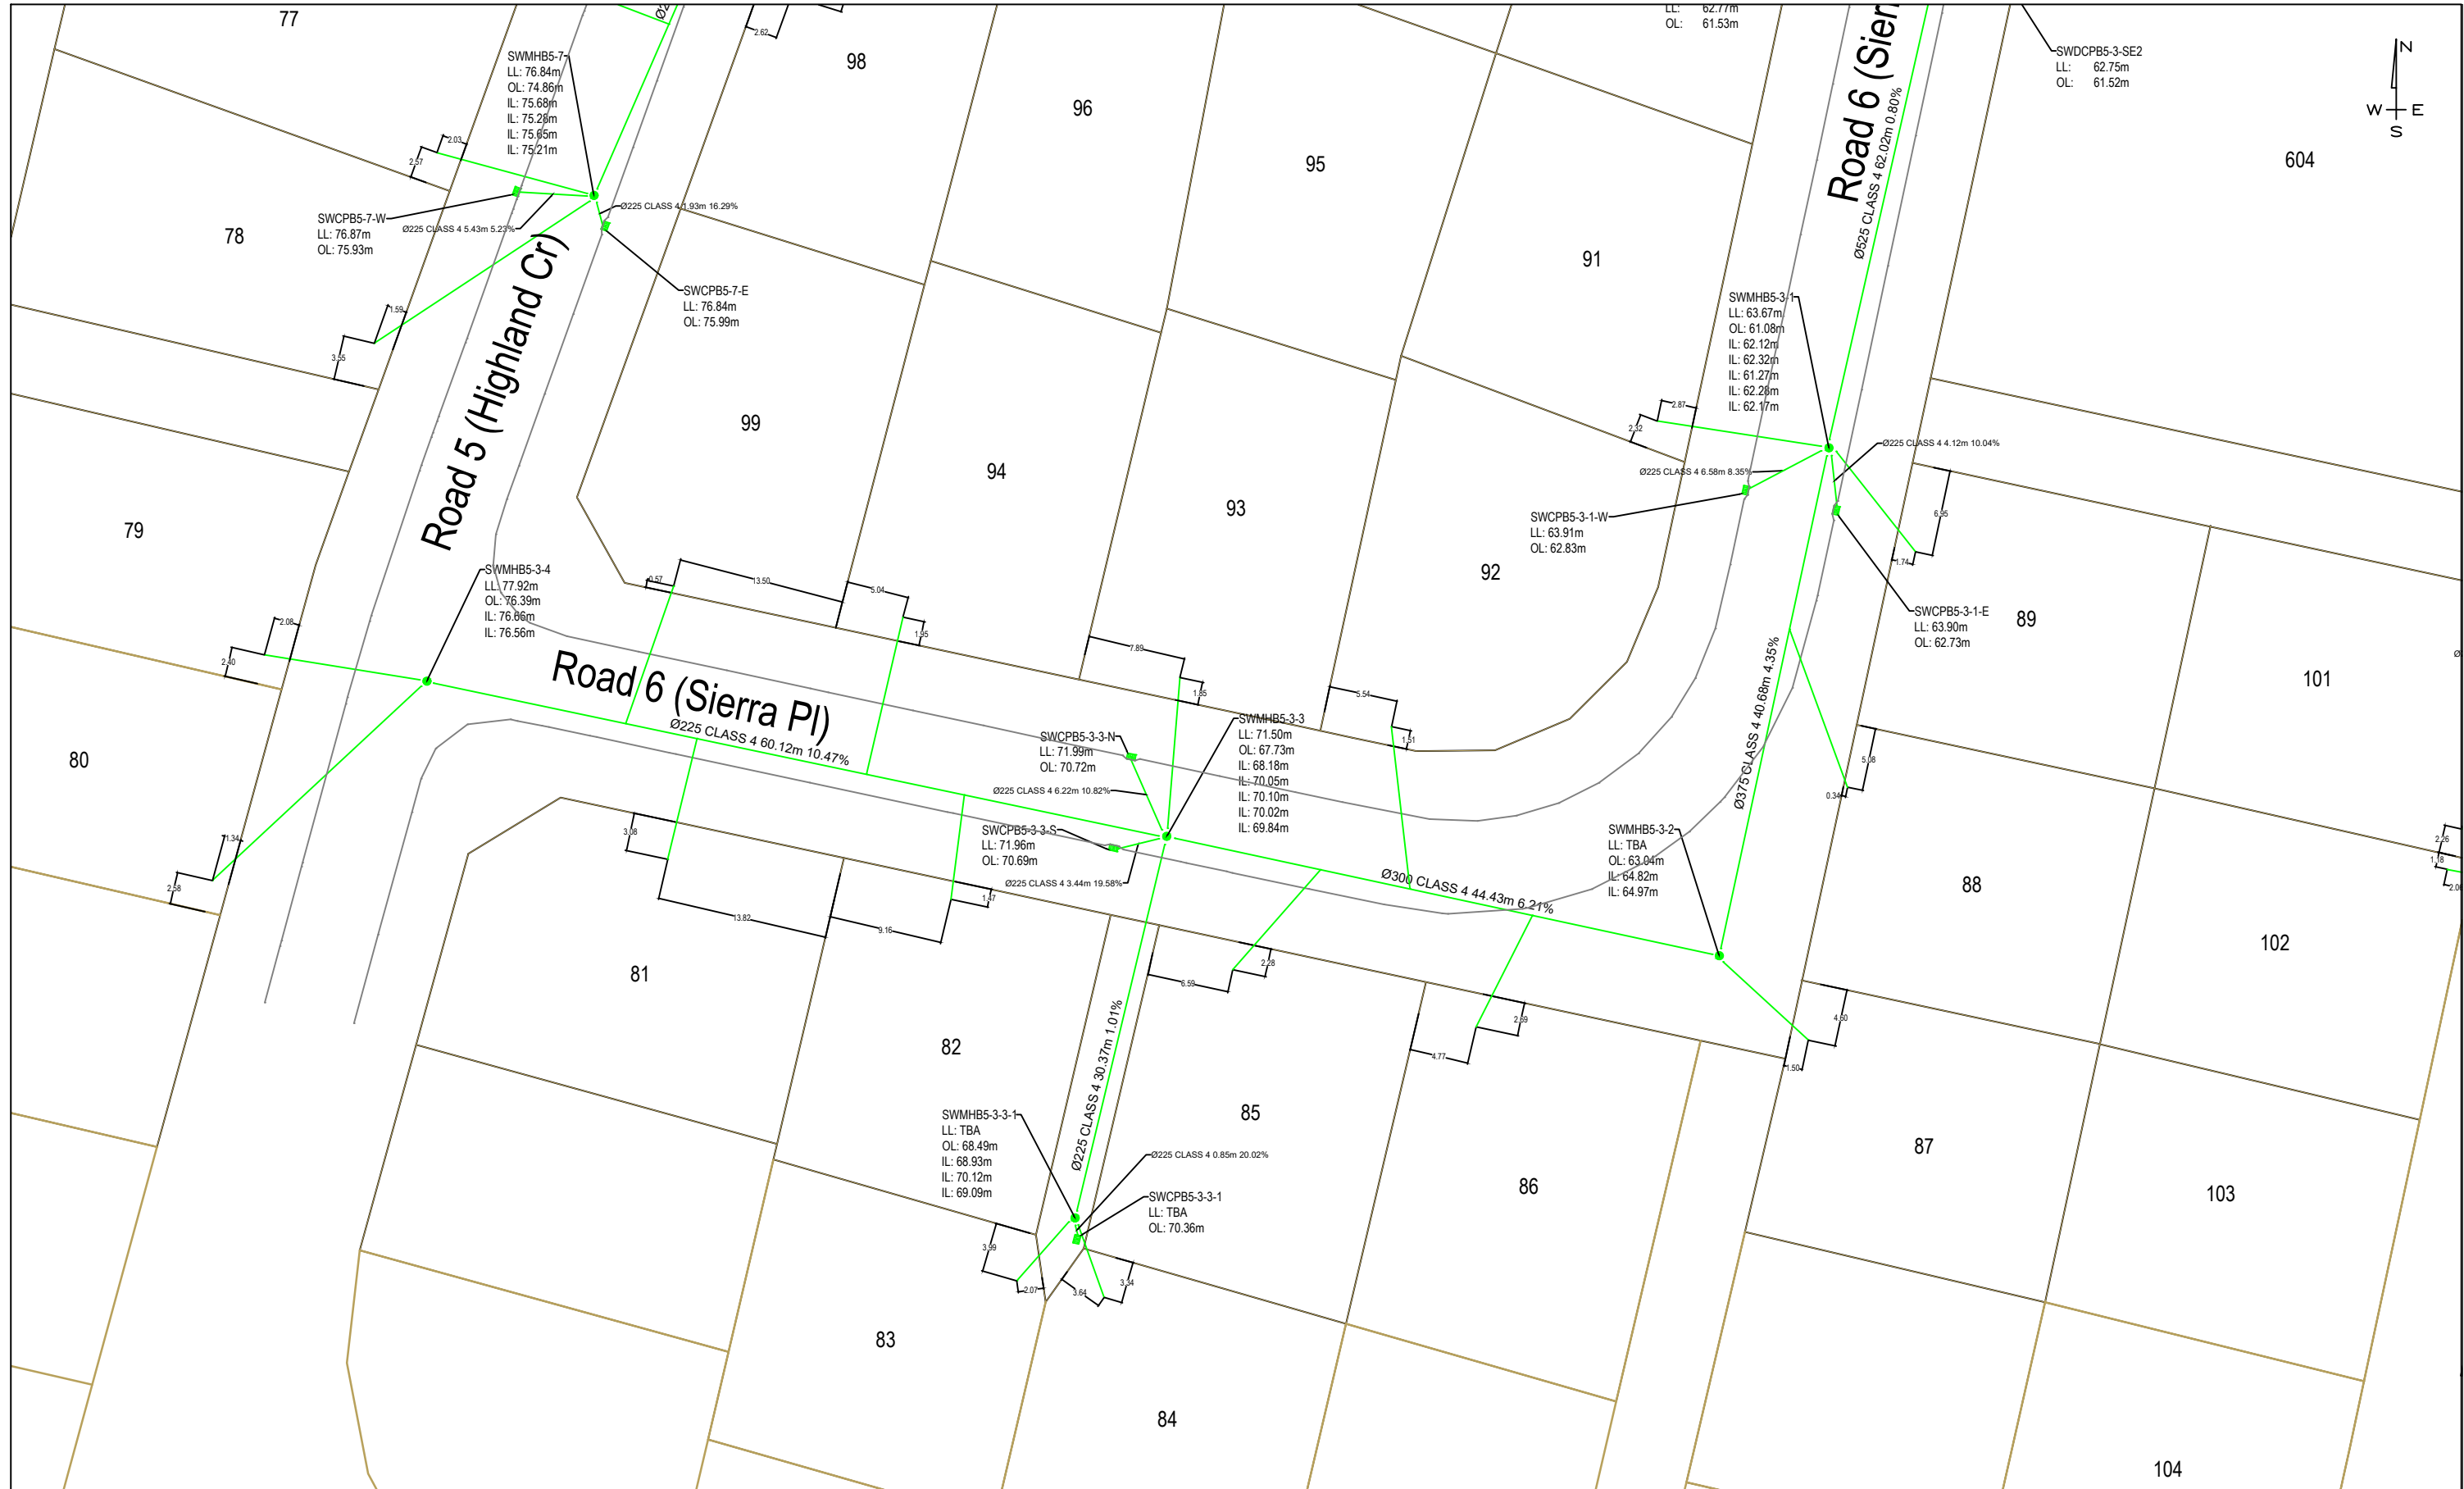

**KEY:**

	POWER		BOUNDARY
	TELECOM		STORMWATER MANHOLE
	GAS		WASTEWATER MANHOLE
	FIBRE		SLUICE VALVE
	SEWER		FIRE HYDRANT
	STORMWATER		
	WATER		

**NOTE:**  
 INVERTS ARE LISTED CLOCKWISE FROM OUTLET.  
 LOT CONNECTIONS ARE Ø100 UNLESS OTHERWISE SHOWN.

1:500@A3

Datum: E: 447149.730  
 NZGD 2000 N: 675183.238  
 Moturiki 1953 H: 52.998

Revision	Amendment	Approved	Revision Date
A	Original Issue	J. M.	22-03-22




**FRONTIER ESTATE**

Surveyed	Approved	Approved Date
J. M.	J. M.	22-03-22
Drawn	Scales	
L. D.	1:500	

Project  
 Frontier Estate  
 Stage 4  
 Pirongia Rd, Te Awamutu

Sheet  
**STORMWATER SERVICE AS BUILT PLAN**

Project No.	Sheet No.	Revision
8940-400-S02	002	A

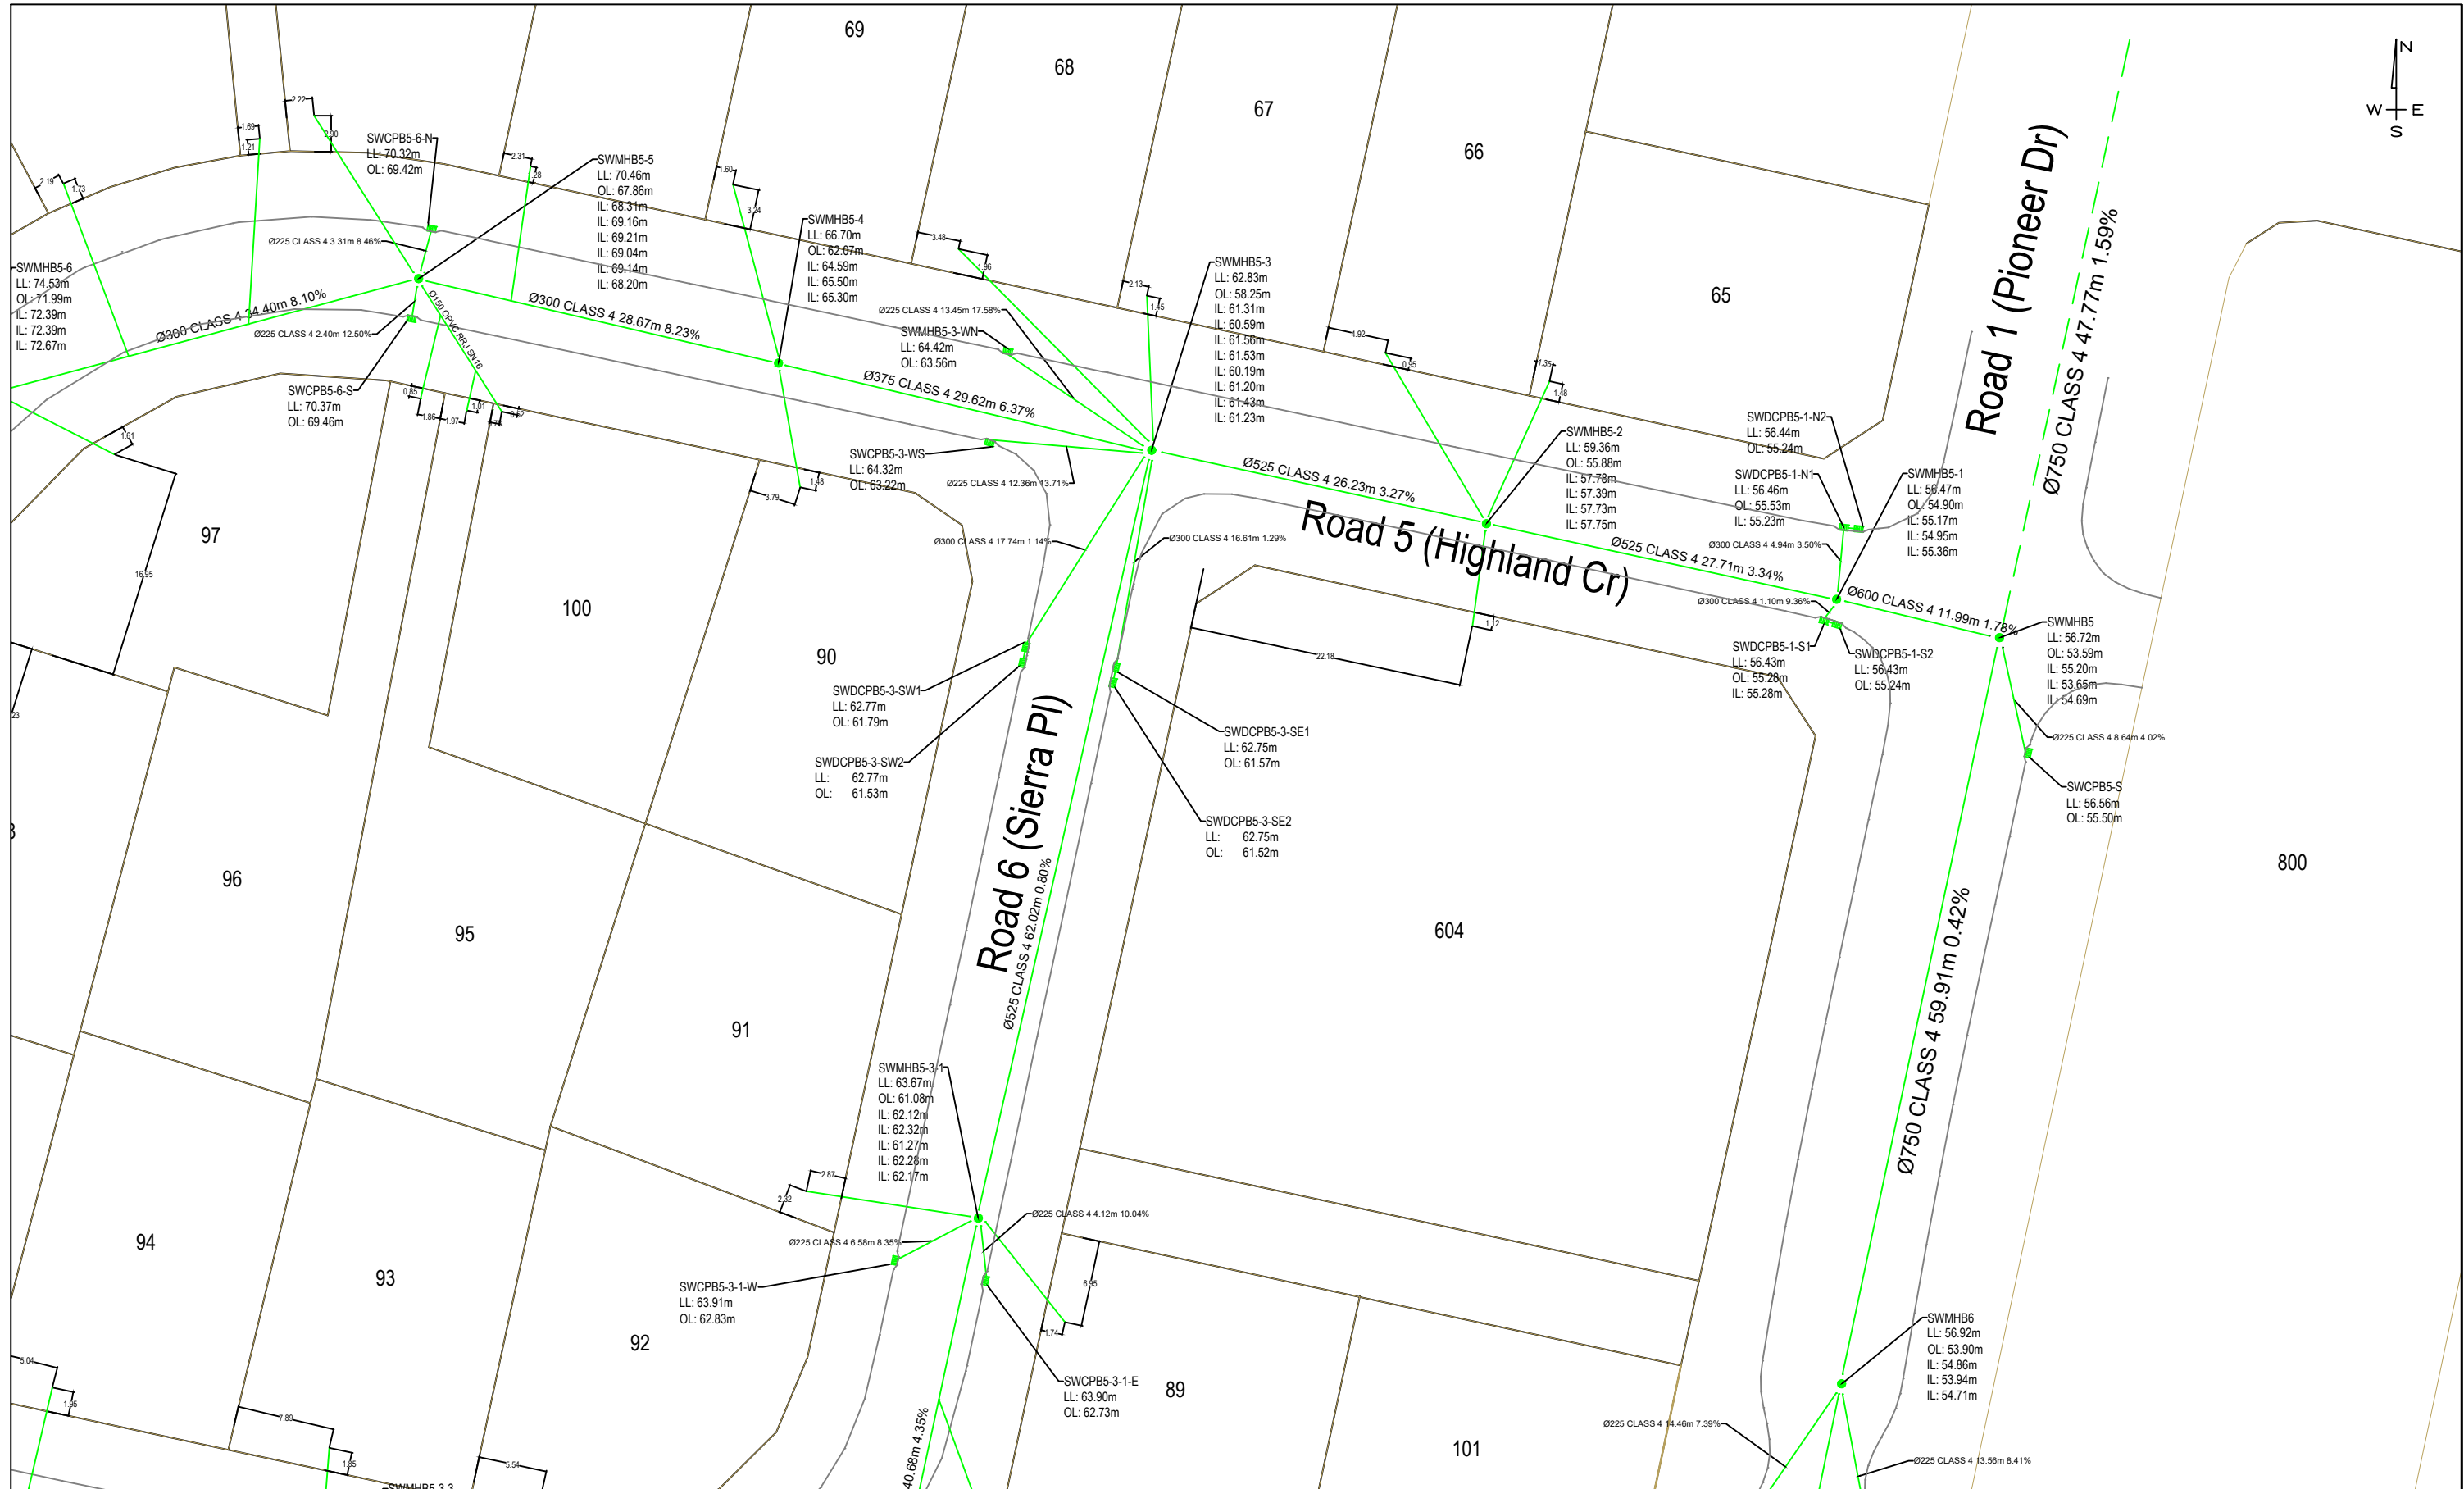

**KEY:**

	POWER		BOUNDARY
	TELECOM		STORMWATER MANHOLE
	GAS		WASTEWATER MANHOLE
	FIBRE		SLUICE VALVE
	SEWER		FIRE HYDRANT
	STORMWATER		
	WATER		

**NOTE:**  
 INVERTS ARE LISTED CLOCKWISE FROM OUTLET.  
 LOT CONNECTIONS ARE Ø100 UNLESS OTHERWISE SHOWN.




Datum: E: 447149.730  
 NZGD 2000 N: 675183.238  
 Moturiki 1953 H: 52.998

Revision	Amendment	Approved	Revision Date
A	Original Issue	J. M.	22-03-22



Surveyed	Approved	Approved Date
L. D.	J. M.	22-03-22
Drawn	Scales	
L. D.	1:500	

Project	
Frontier Estate Stage 4 Pirongia Rd, Te Awamutu	
Sheet	
STORMWATER SERVICE AS BUILT PLAN	
Project No.	Sheet No.
8940-400-S03	003
Revision	
A	

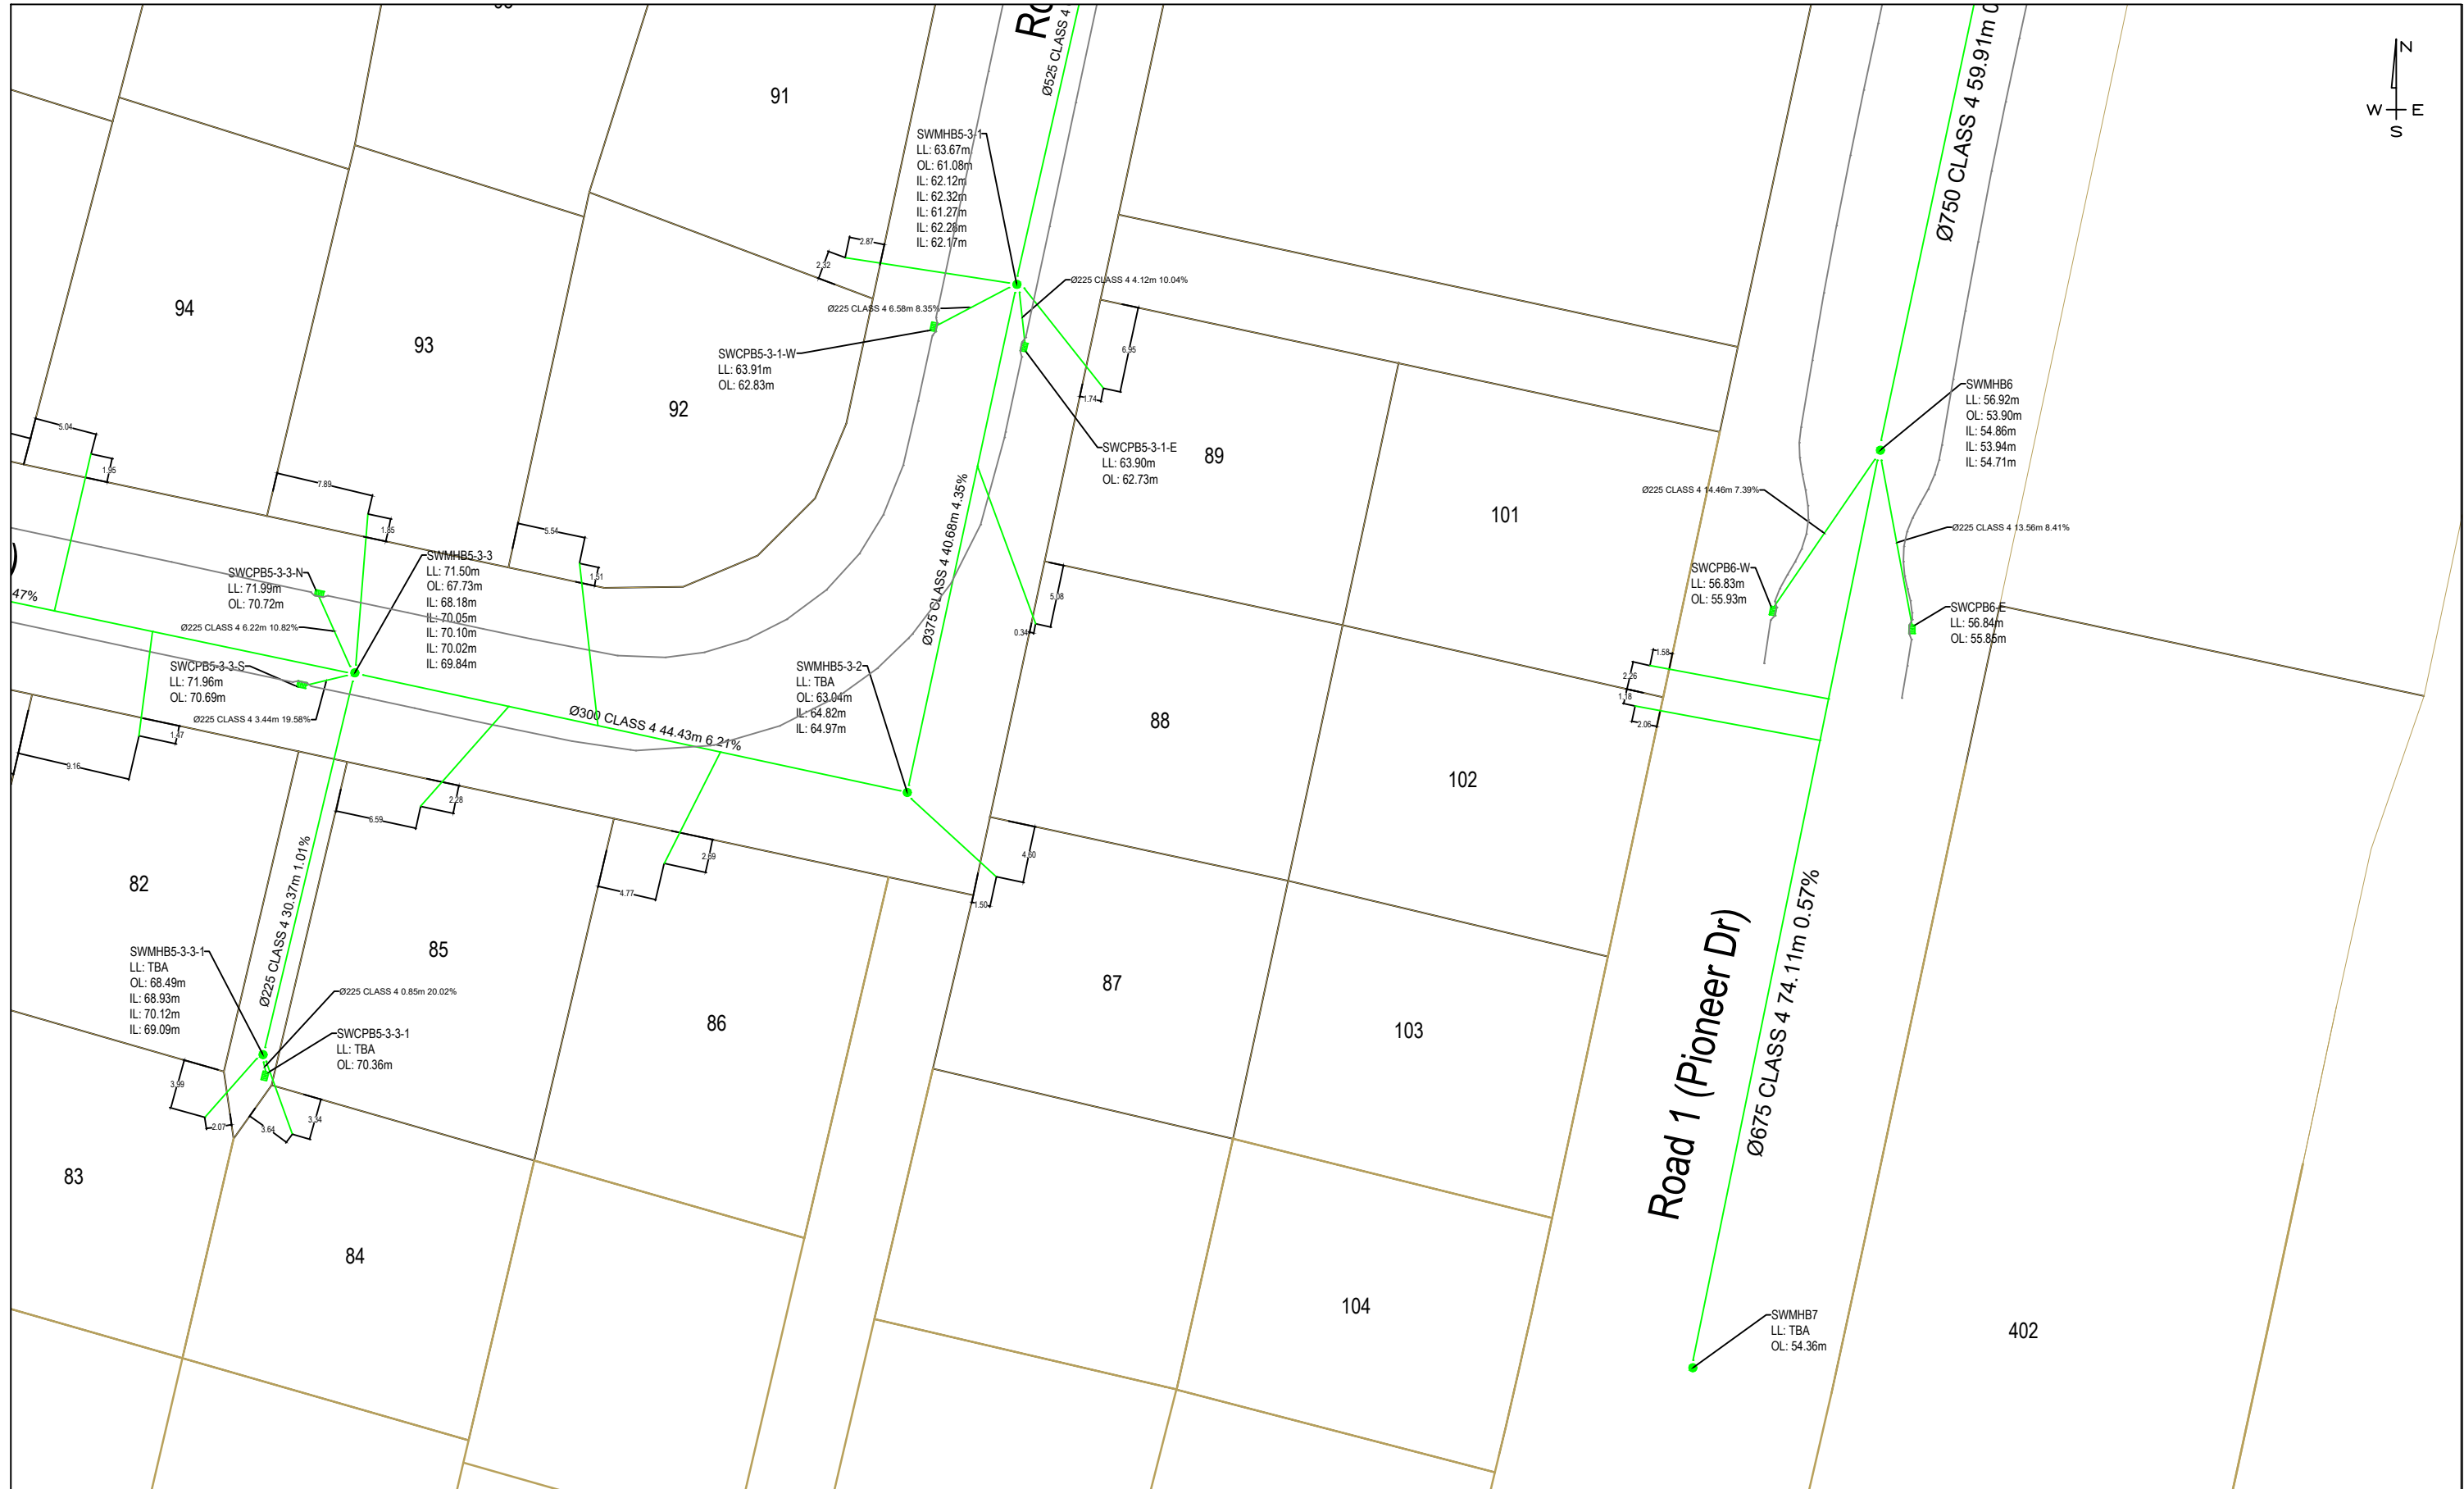

**KEY:**

	POWER		BOUNDARY
	TELECOM		STORMWATER MANHOLE
	GAS		WASTEWATER MANHOLE
	FIBRE		SLUICE VALVE
	SEWER		FIRE HYDRANT
	STORMWATER		
	WATER		

**NOTE:**  
 INVERTS ARE LISTED CLOCKWISE FROM OUTLET.  
 LOT CONNECTIONS ARE Ø100 UNLESS OTHERWISE SHOWN.

1:500@A3

Datum: E: 447149.730  
 NZGD 2000 N: 675183.238  
 Moturiki 1953 H: 52.998

Revision	Amendment	Approved	Revision Date
A	Original Issue	J. M.	22-03-22





**FRONTIER ESTATE**

Surveyed	Approved	Approved Date
	J. M.	22-03-22
Drawn	Scales	
L. D.	1:500	

Project	
Frontier Estate Stage 4 Pirongia Rd, Te Awamutu	
Sheet	
STORMWATER SERVICE AS BUILT PLAN	
Project No.	Sheet No. / Revision
8940-400-S04	004 / A



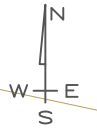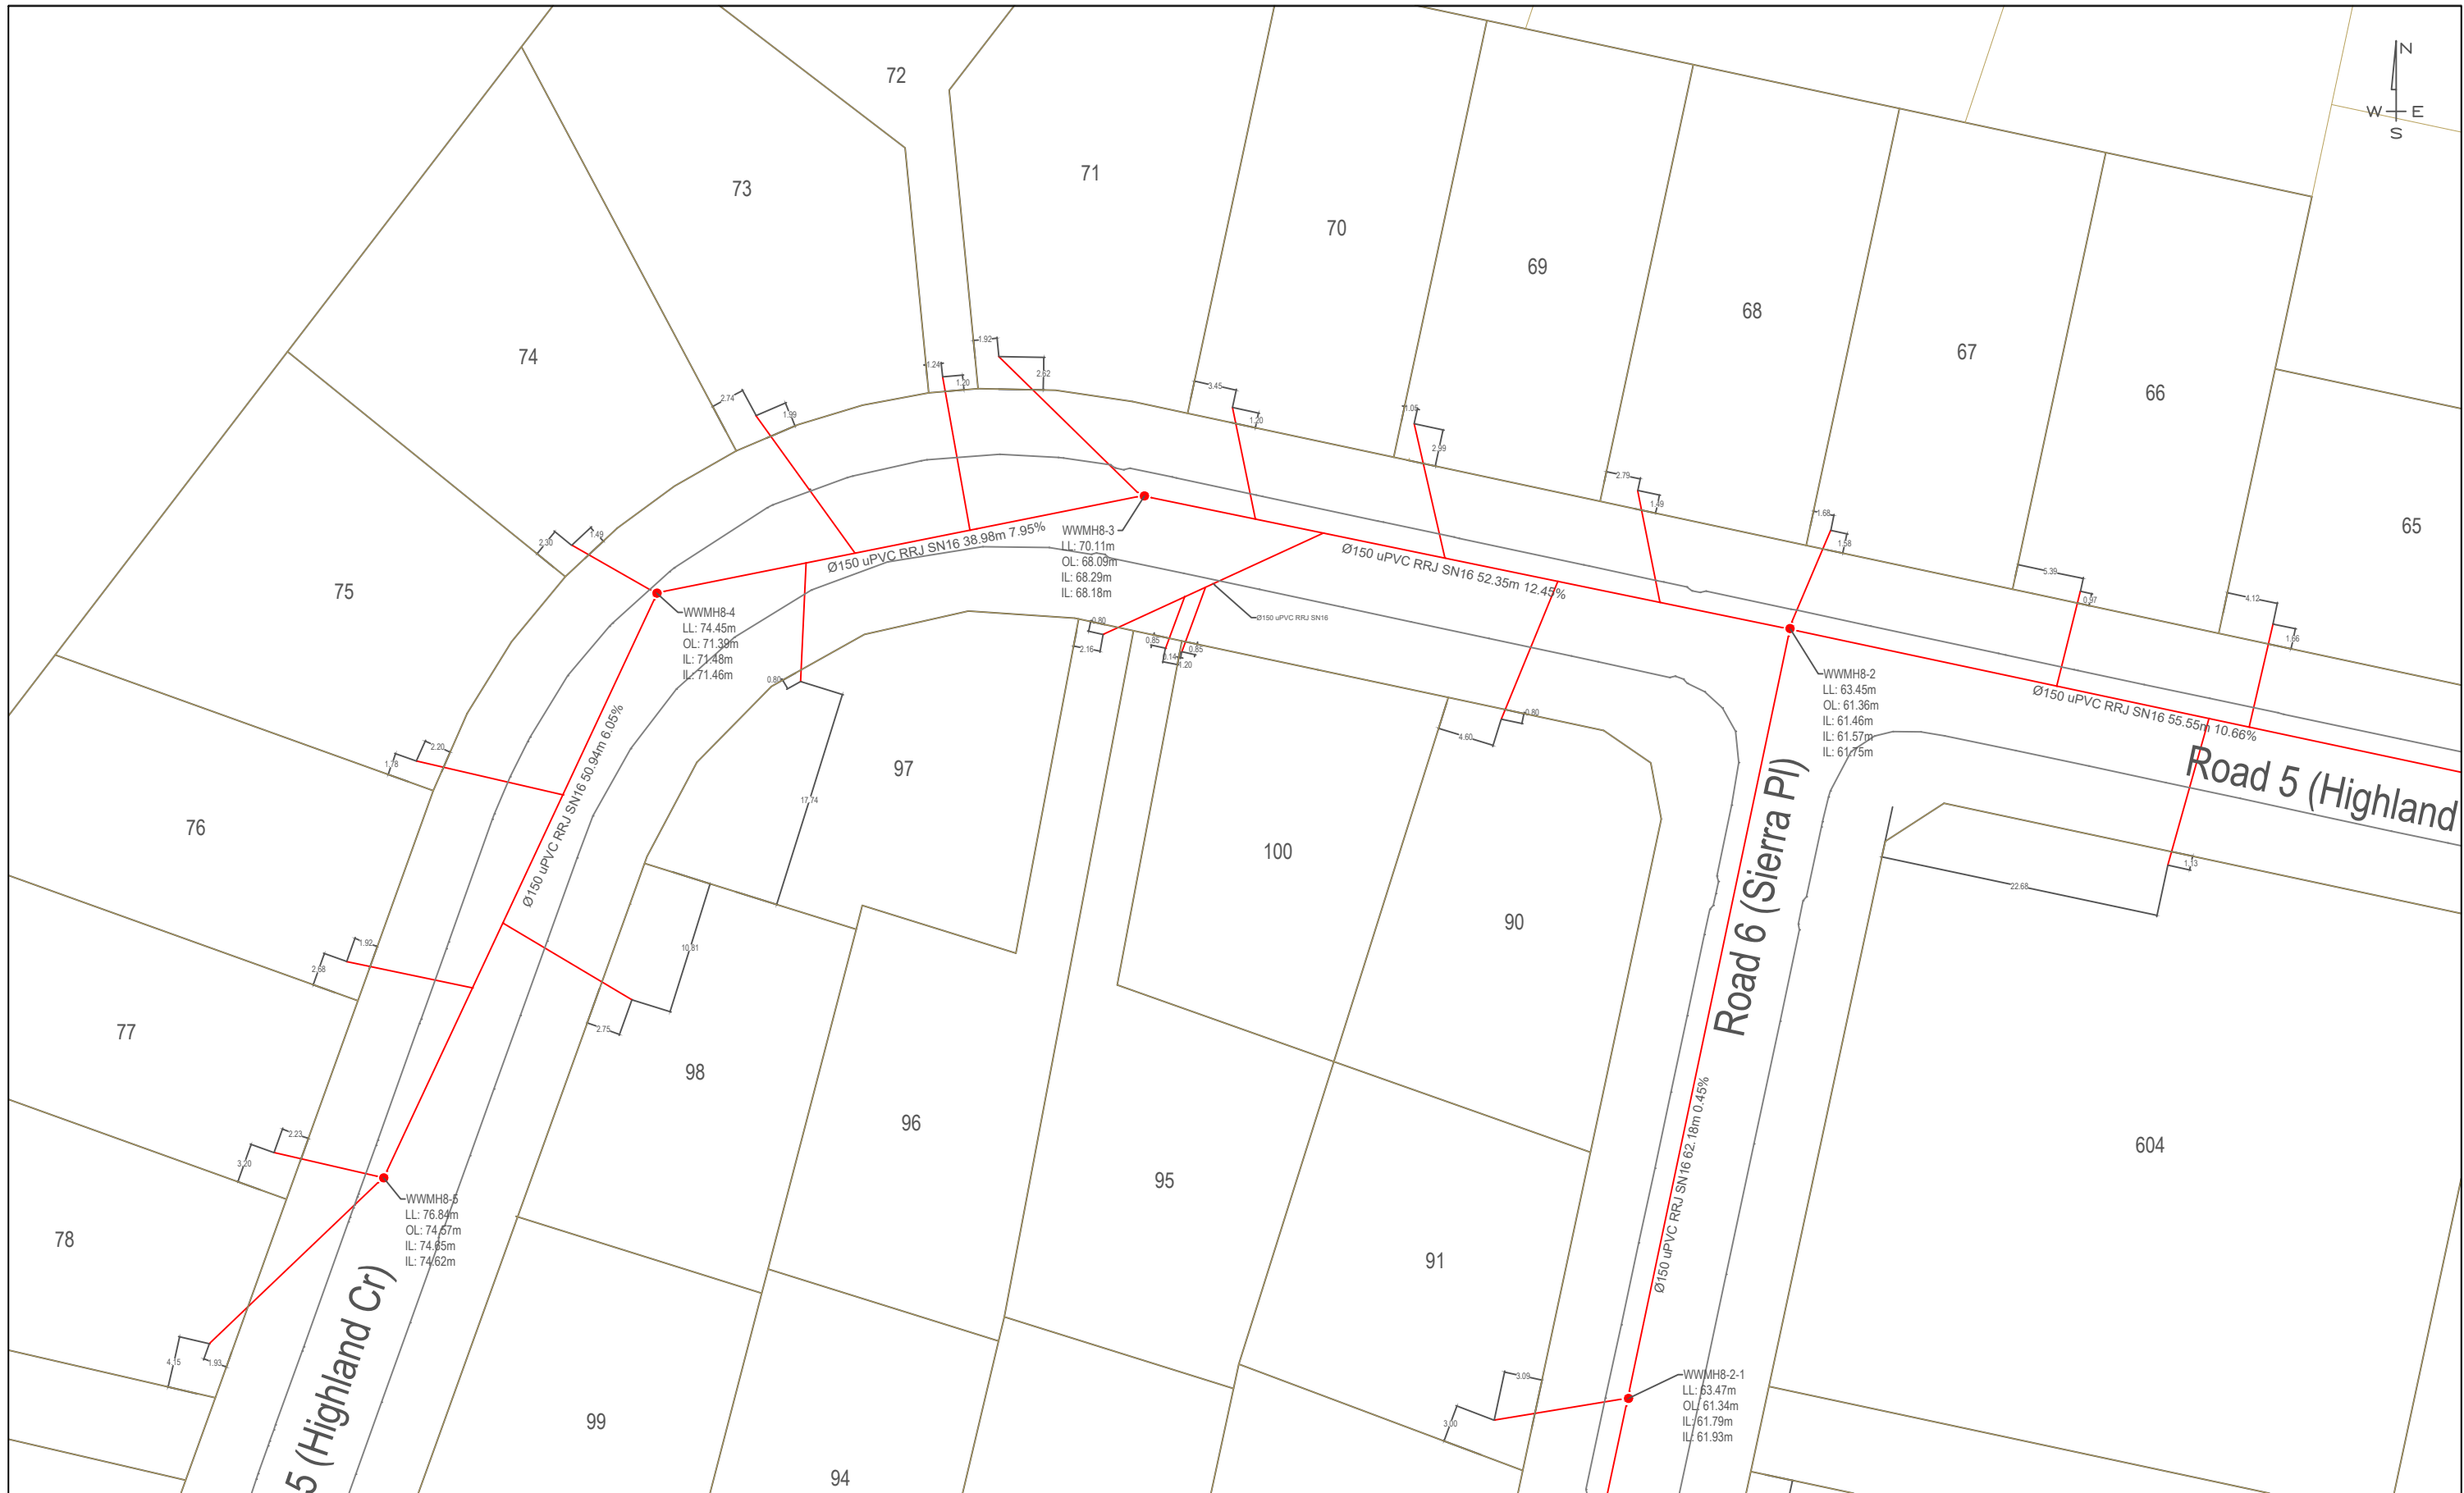

**KEY:**

	POWER		BOUNDARY
	GAS		STORMWATER MANHOLE
	TELECOM		WASTEWATER MANHOLE
	FIBRE		SLUICE VALVE
	WASTEWATER		FIRE HYDRANT
	STORMWATER		
	SUPPLY WATER		

**NOTE:**  
 INVERTS ARE LISTED CLOCKWISE FROM OUTLET.  
 LOT CONNECTIONS ARE Ø100 UNLESS OTHERWISE SHOWN.

1:500@A3


Datum: E: 447149.730  
 NZGD 2000 N: 675183.238  
 Moturiki 1953 H: 52.998

Revision	Amendment	Approved	Revised Date
A	Original Issue	J. M.	22-03-22

P: 07 849 0600 E: info@hamiltonasphalts.co.nz

Surveyed: J. M. Approved Date: 22-03-22  
 Drawn: L. D. Scale: 1:500

Project	
Frontier Estate Stage 4 Pirongia Rd, Te Awamutu	
Sheet	
WASTEWATER SERVICE AS BUILT PLAN	
Project No.	Sheet No. / Revision
8940-500-S01	001 / A

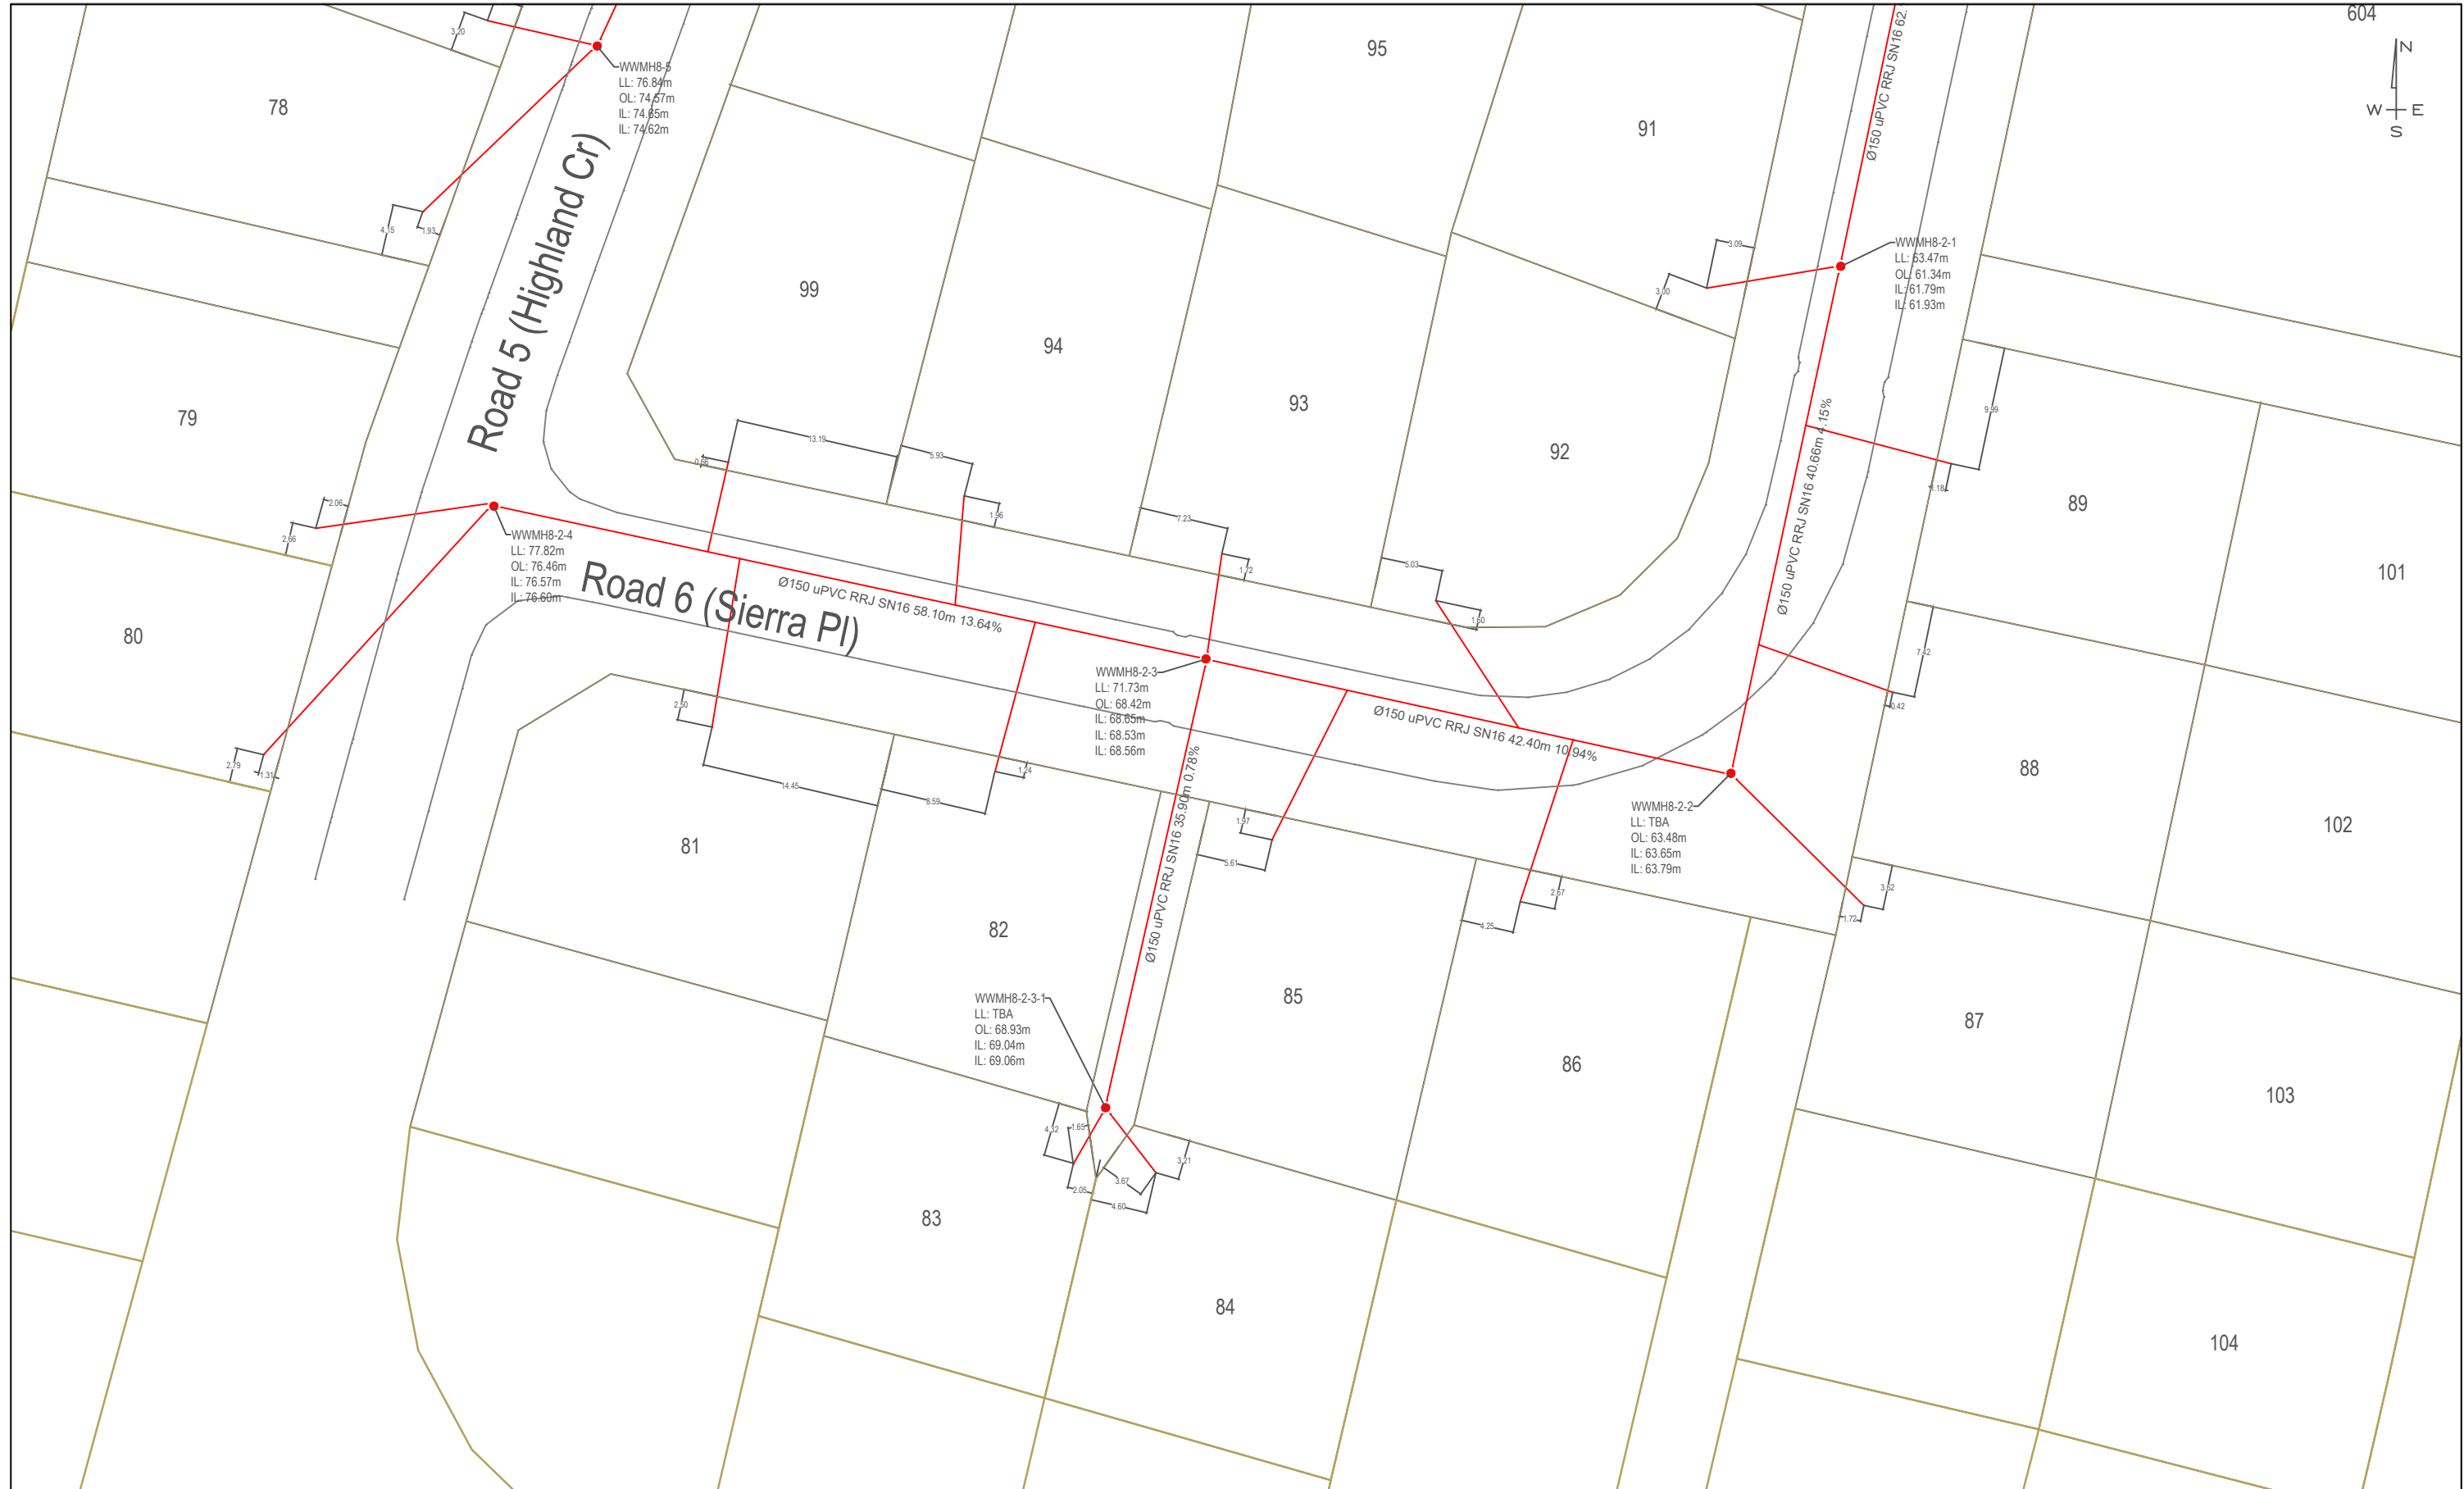

**KEY:**

- POWER
- GAS
- TELECOM
- FIBRE
- WASTEWATER
- STORMWATER
- SUPPLY WATER

- BOUNDARY
- STORMWATER MANHOLE
- WASTEWATER MANHOLE
- X SLUICE VALVE
- FIRE HYDRANT

**NOTE:**  
 INVERTS ARE LISTED CLOCKWISE FROM OUTLET.  
 LOT CONNECTIONS ARE Ø100 UNLESS OTHERWISE SHOWN.

1:500@A3

Datum: E: 447149.730  
 NZGD 2000 N: 675183.238  
 Moturiki 1953 H: 52.998

Revision	Amendment	Approved	Revised Date
A	Original Issue	J. M.	22-03-22

P: 07 849 0600 E: info@hamiltonasphalts.co.nz


Surveyed: J. M. Approved: J. M. Approved Date: 22-03-22  
 Drawn: L. D. Scale: 1:500

Project: Frontier Estate Stage 4  
 Pirongia Rd, Te Awamutu

Sheet: WASTEWATER SERVICE AS BUILT PLAN

Project No: 8940-500-S02

Sheet No.	Revision
002	A

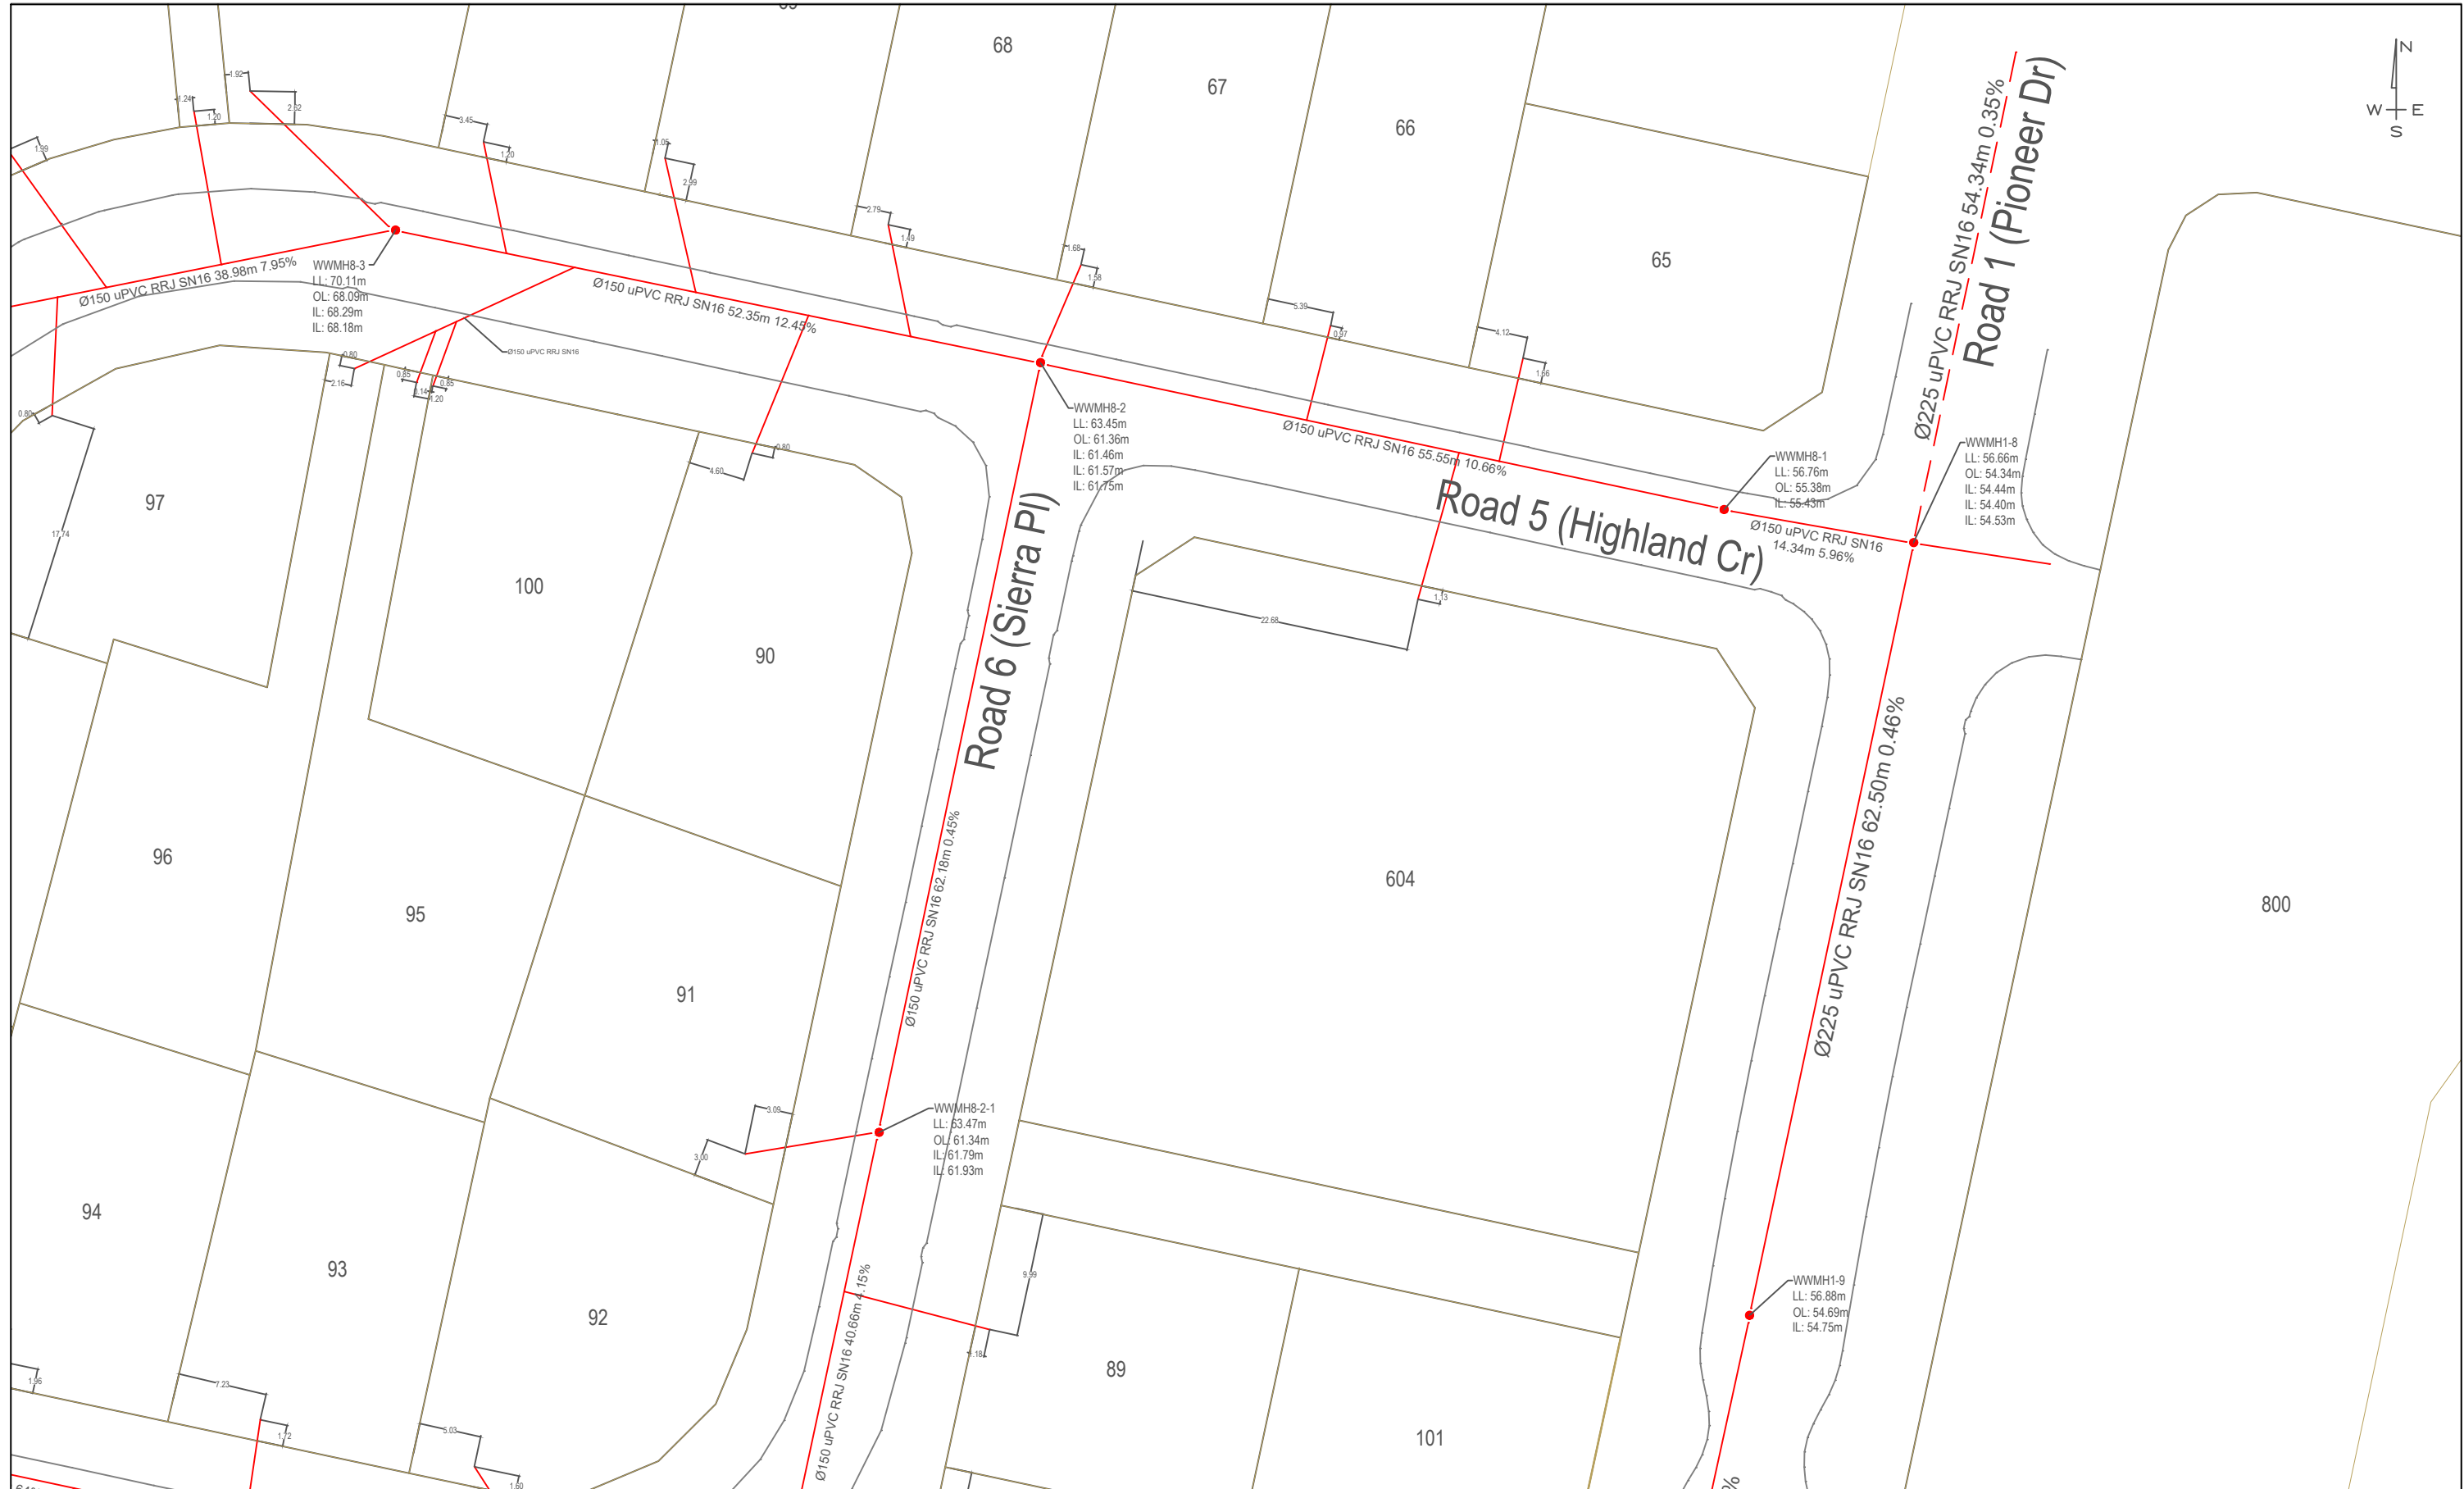

**KEY:**

	POWER		BOUNDARY
	GAS		STORMWATER MANHOLE
	TELECOM		WASTEWATER MANHOLE
	FIBRE		SLUICE VALVE
	WASTEWATER		FIRE HYDRANT
	STORMWATER		
	SUPPLY WATER		

**NOTE:**  
 INVERTS ARE LISTED CLOCKWISE FROM OUTLET.  
 LOT CONNECTIONS ARE Ø100 UNLESS OTHERWISE SHOWN.

1:500@A3


Datum: E: 447149.730  
 NZGD 2000 N: 675183.238  
 Moturiki 1953 H: 52.998

Revision	Amendment	Approved	Revised Date
A	Original Issue	J. M.	22-03-22

P: 07 849 0600 E: info@hamiltonasphalts.co.nz

Surveyed: J. M. Approved: J. M. Approved Date: 22-03-22  
 Drawn: L. D. Scale: 1:500

Project	
Frontier Estate Stage 4 Pirongia Rd, Te Awamutu	
Sheet	
WASTEWATER SERVICE AS BUILT PLAN	
Project No.	Sheet No. / Revision
8940-500-S03	003 / A

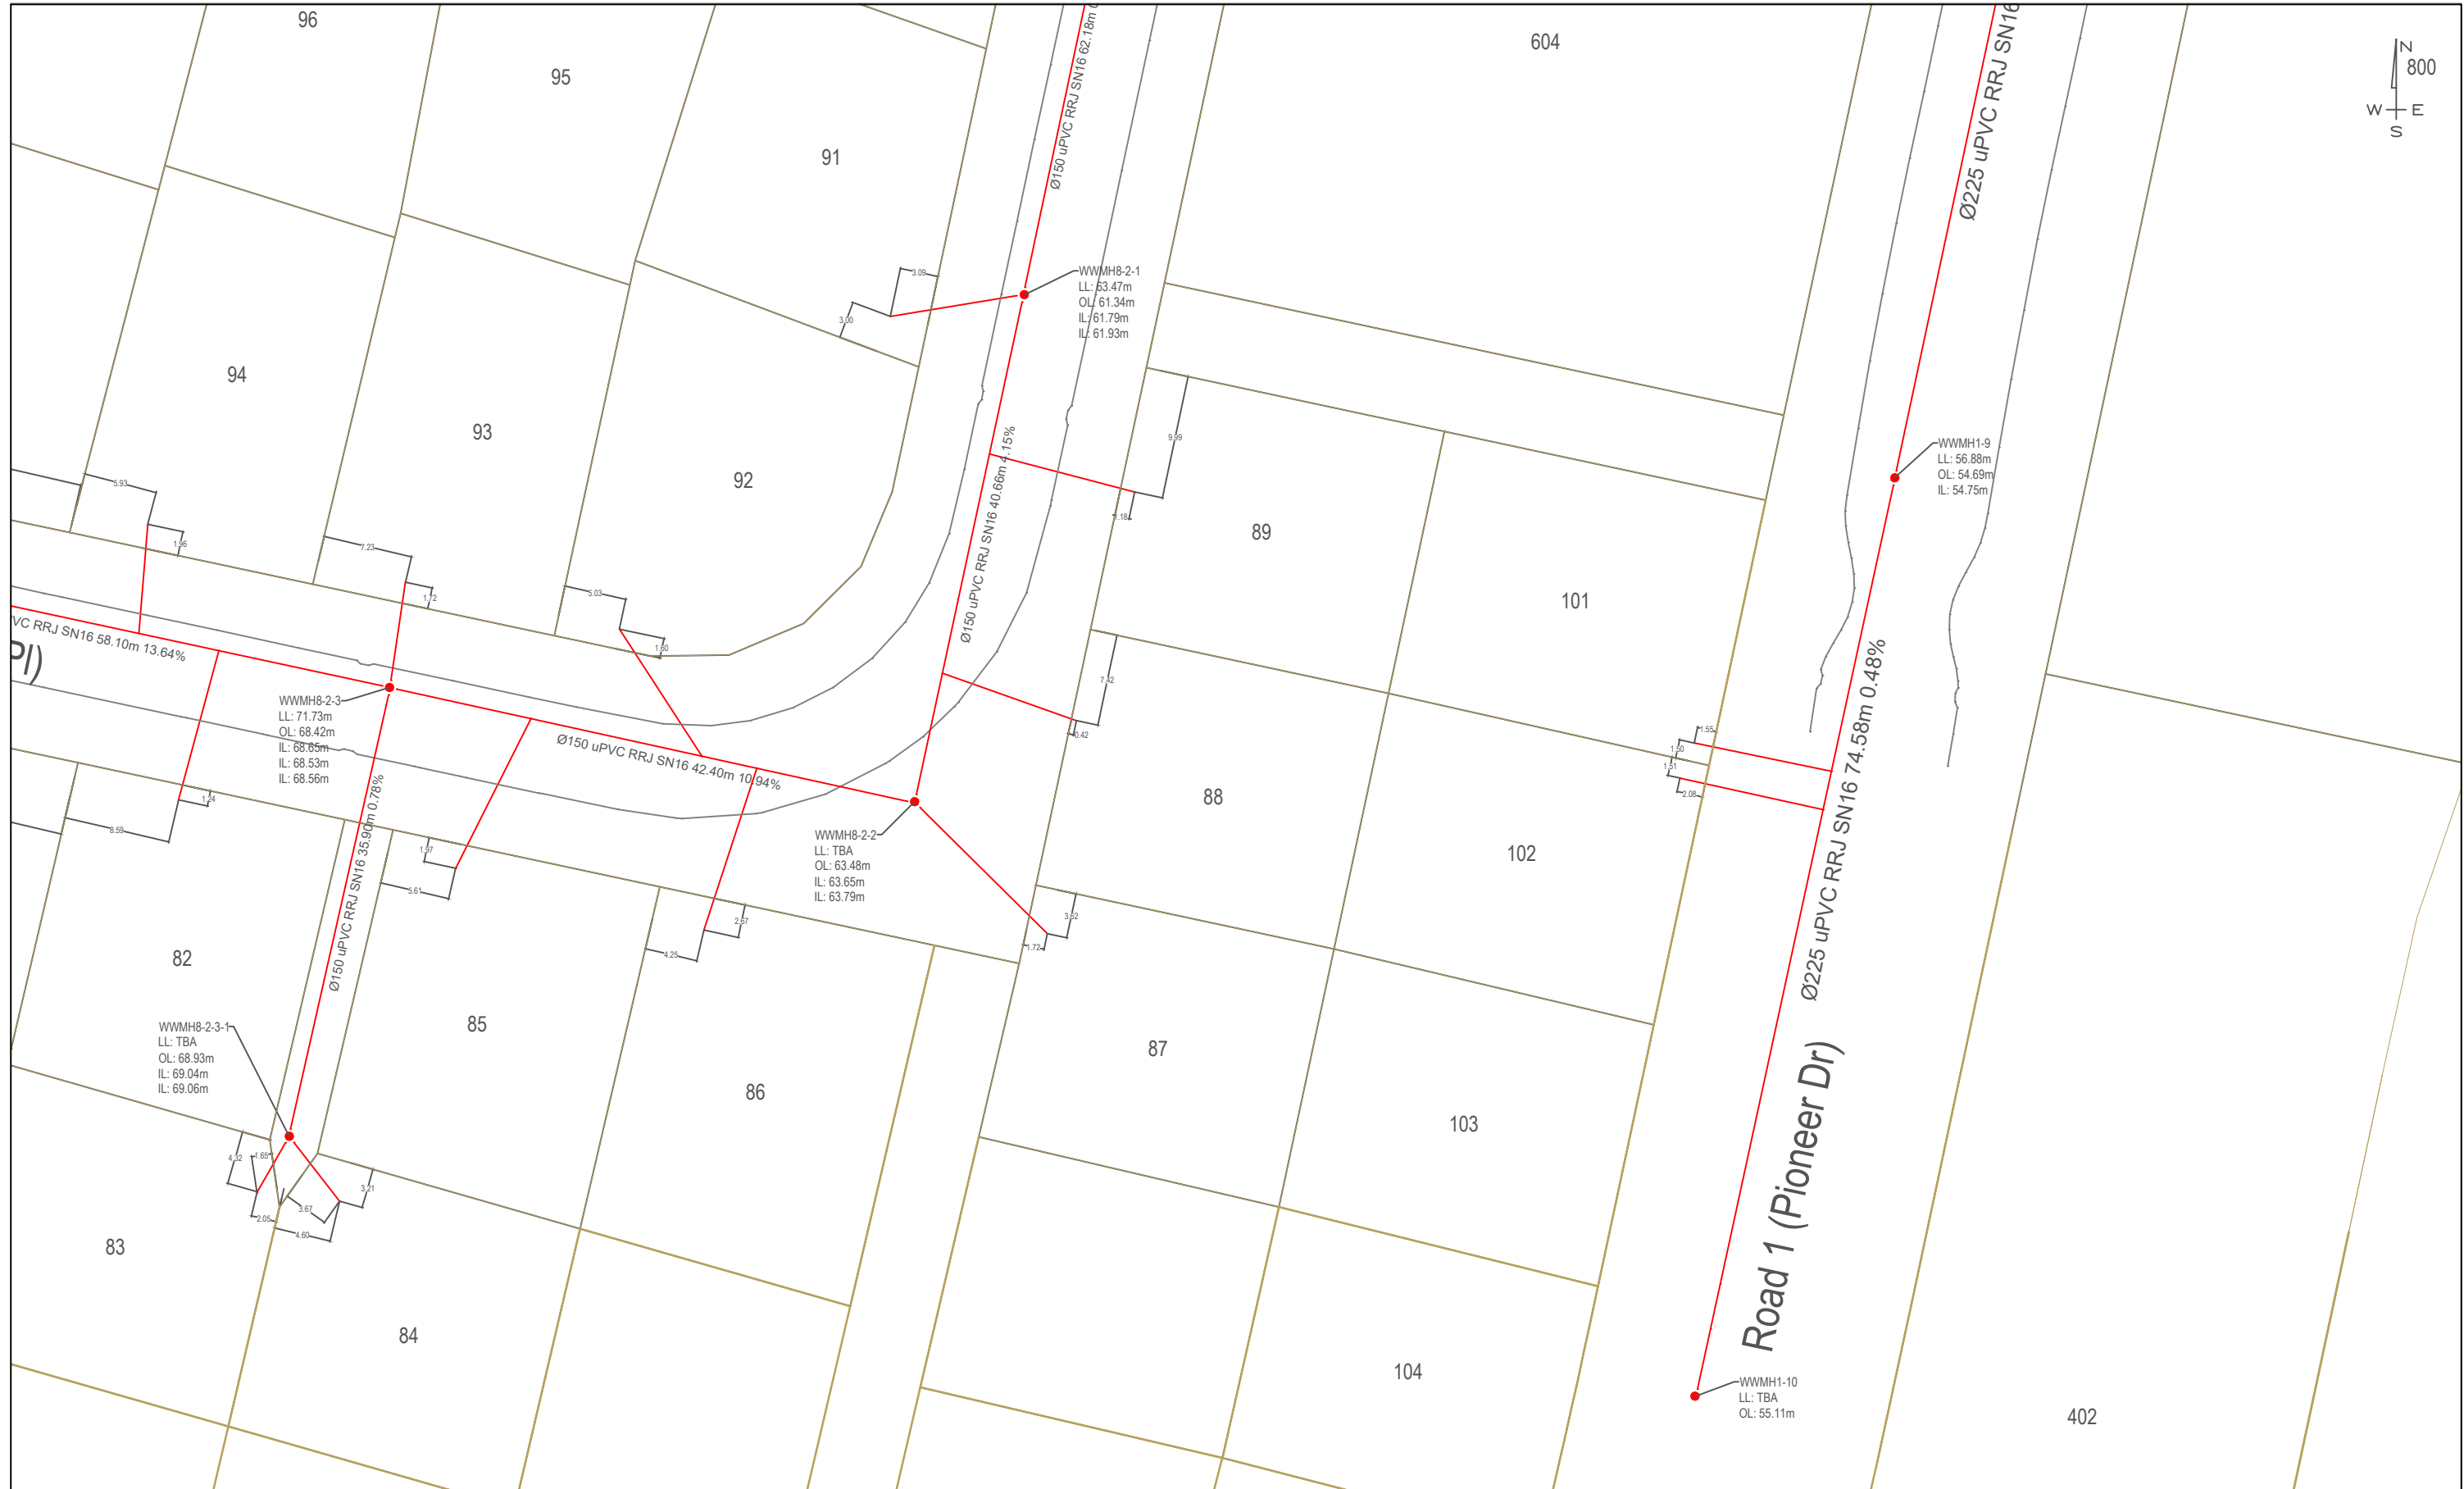

**KEY:**

	POWER		BOUNDARY
	GAS		STORMWATER MANHOLE
	TELECOM		WASTEWATER MANHOLE
	FIBRE		SLUICE VALVE
	WASTEWATER		FIRE HYDRANT
	STORMWATER		
	SUPPLY WATER		

**NOTE:**  
 INVERTS ARE LISTED CLOCKWISE FROM OUTLET.  
 LOT CONNECTIONS ARE Ø100 UNLESS OTHERWISE SHOWN.

1:500@A3

Datum: E: 447149.730  
 NZGD 2000 N: 675183.238  
 Moturiki 1953 H: 52.998

Revision	Amendment	Approved	Revised Date
A	Original Issue	J. M.	22-03-22

P: 07 849 0600 E: info@hamiltonasphalts.co.nz

Surveyed: J. M. Approved: J. M. Approved Date: 22-03-22  
 Drawn: L. D. Scale: 1:500

Project	
Frontier Estate Stage 4 Pirongia Rd, Te Awamutu	
Sheet	
WASTEWATER SERVICE AS BUILT PLAN	
Project No.	Sheet No. / Revision
8940-500-S04	004 / A